


Consultants

This drawing is the property of the Architect and unauthorized reproduction is prohibited under the Copyright Act.
Electronic files when provided are instruments of service and the sole property of Sahuri + partners architecture inc. No alteration or reproduction shall be made without written authorization from Sahuri + partners architecture inc.
The Contractor shall check and verify all dimensions and report any discrepancies to the Architect prior to construction; do not scale this drawing.
This drawing shall not be used for construction unless properly noted as ISSUED FOR CONSTRUCTION by the Architect.
All dimensions are in millimeters unless noted otherwise.

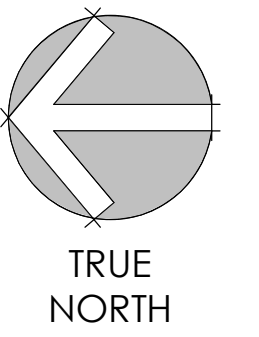

ISSUES/REVISIONS

DATE	DESCRIPTION	#
2017-02-20	ISSUED FOR PRICING	1
2017-04-11	ISSUED FOR TP2	2
2017-05-08	ISSUED FOR TP3	3
2017-06-19	ISSUED FOR TP4	5
2017-07-19	ISSUED FOR IFC	6
2018-09-12	ISSUED FOR AS-BUILTS	7

Seal


Client



Project Title
TRADES FACILITY EXPANSION
2700 COLLEGE WAY
CRANBROOK, BC

Drawing Title
MAIN FLOOR PLAN

Drawing info	Project Number
Scale As indicated	16-034
Date 06/07/16	Drawing Number
Drawn CPL	A201
Checked LM	
Partner LM	

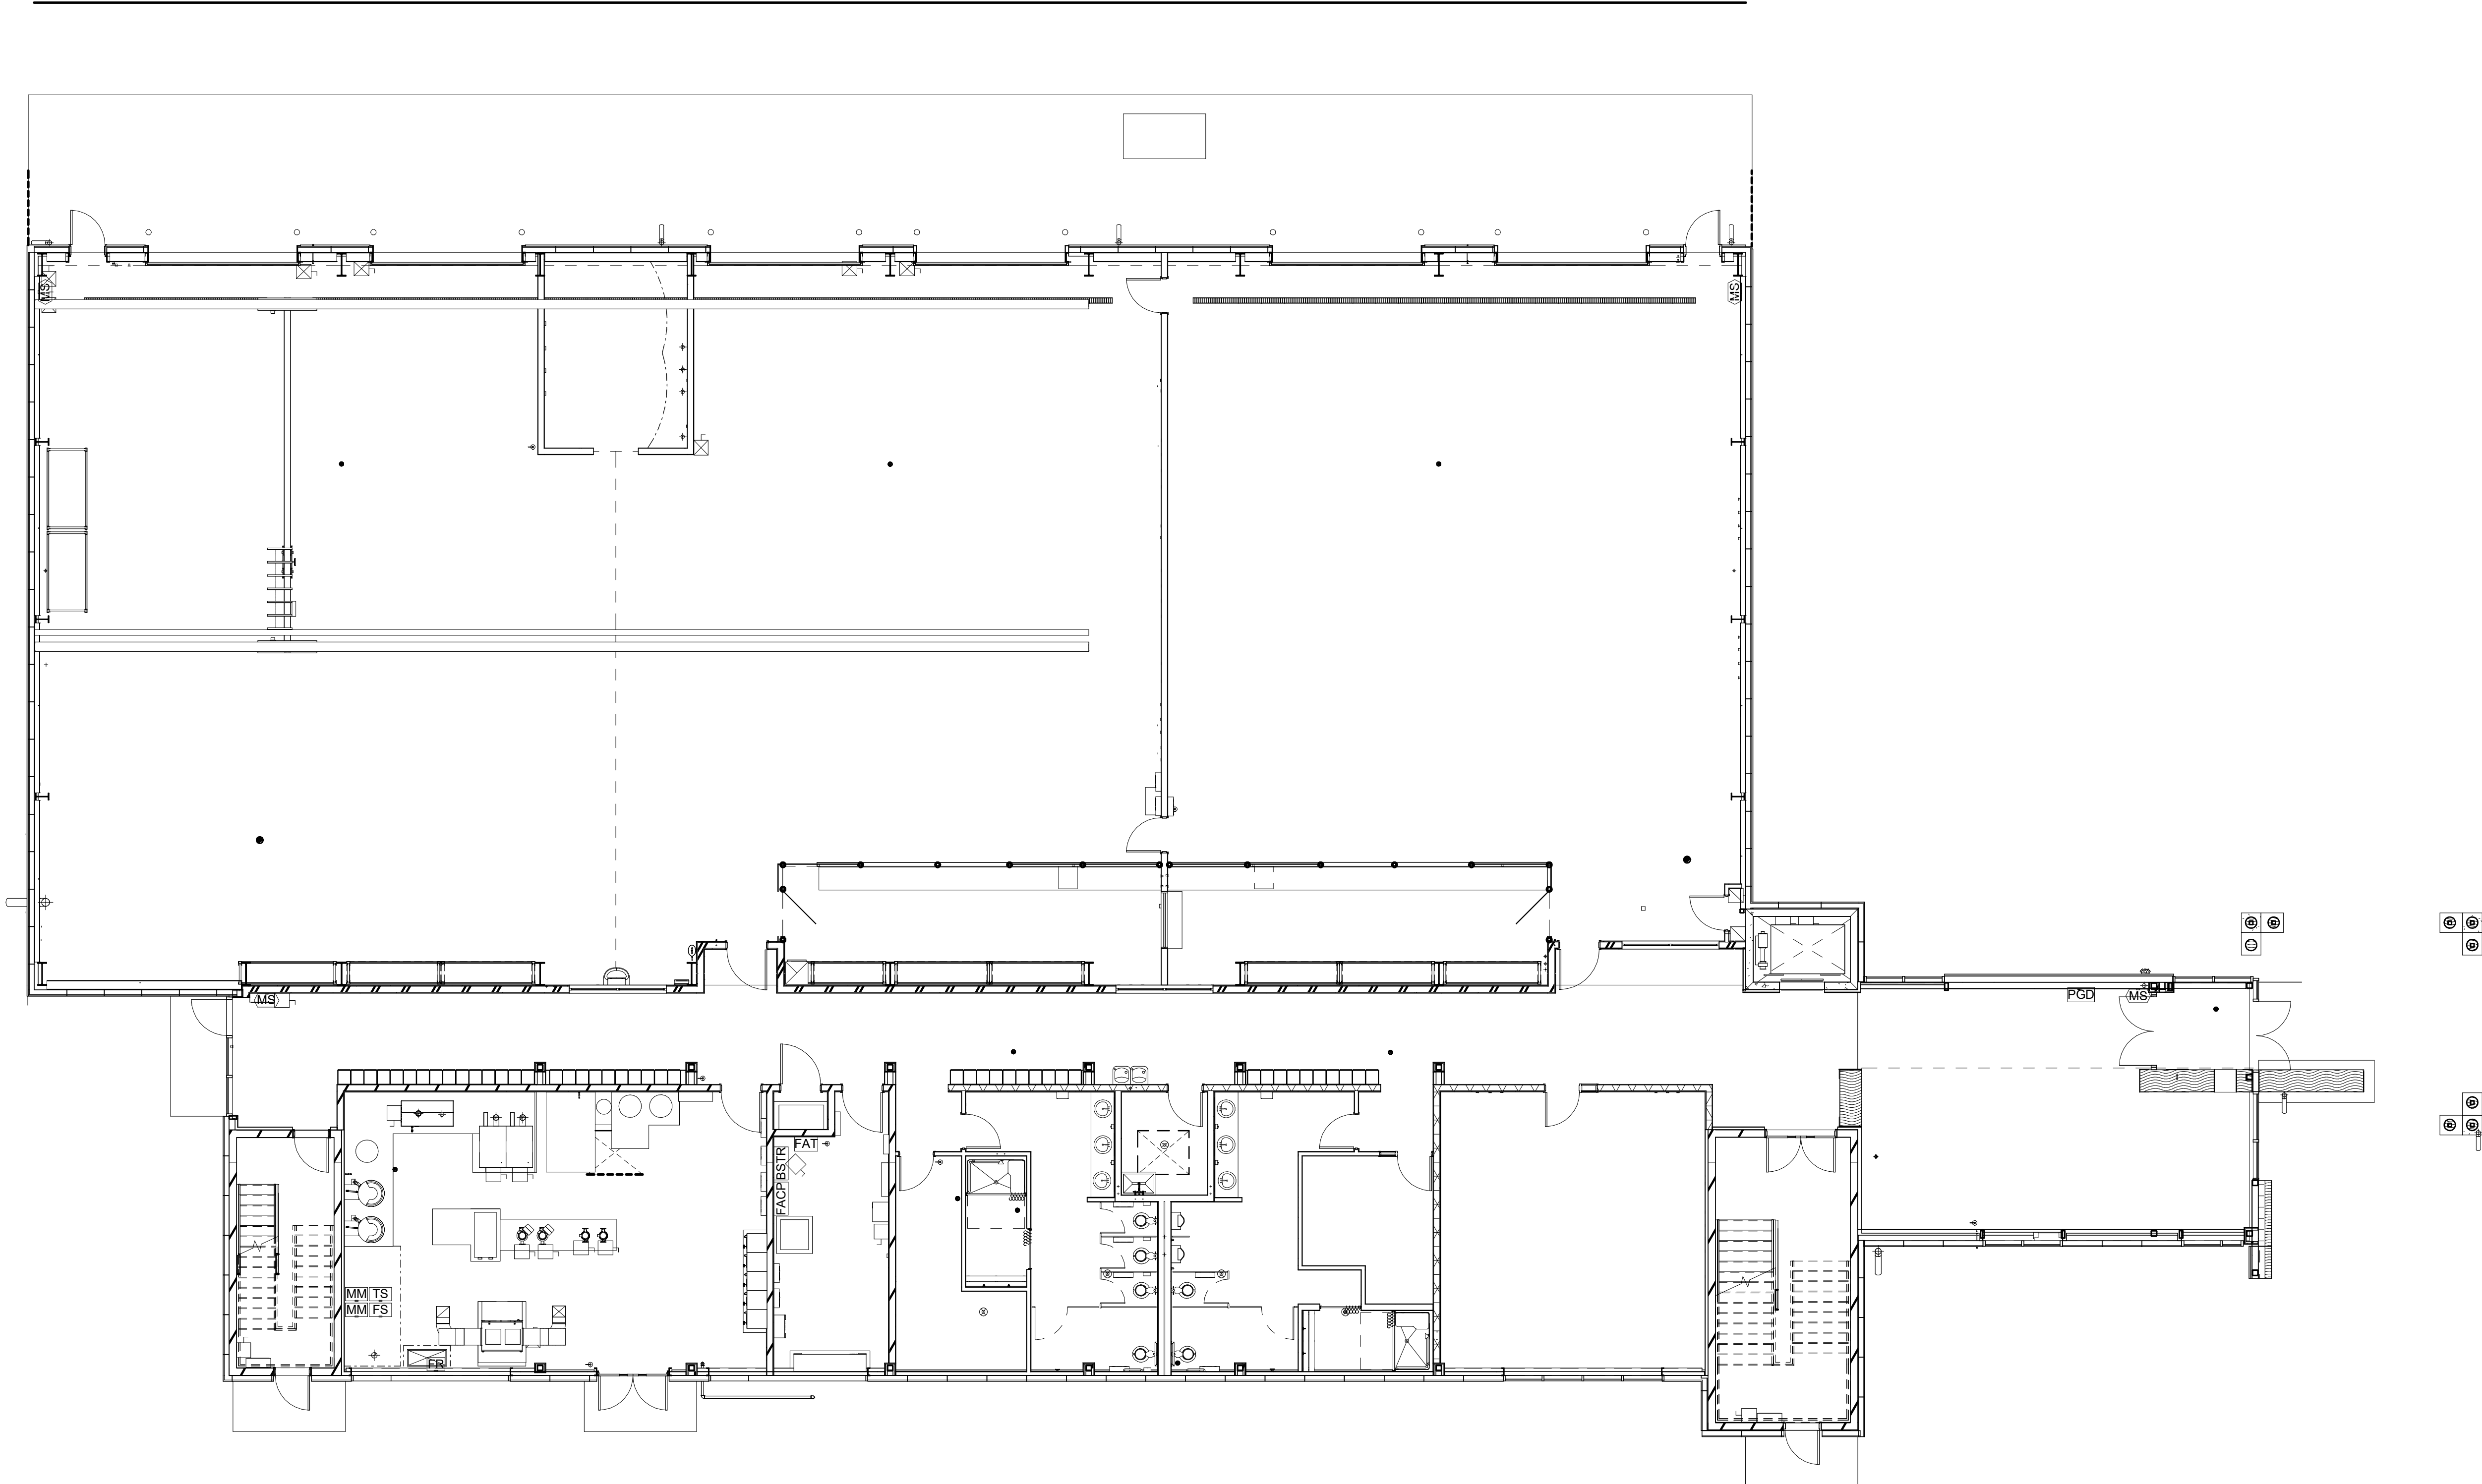

1 MAIN FLOOR PLAN
1 : 100

INTUMESCENT LEGEND	
COLUMN	LOCATION
1	B 2
2	B 4
3	B 5
4	B 7
5	B 8
6	B13
7	B14
8	C 14
9	D13
10	D14

NOTE:
INTUMESCENT COATING UP TO U/S OF SECOND FLOOR DECKING