


Consultants

- This drawing is the property of the Architect and unauthorized reproduction is prohibited under the Copyright Act.
- Electronic files when provided are instruments of service and the sole property of Sahuri + partners architecture inc. No alteration or reproduction shall be made without written authorization from Sahuri + partners architecture inc.
- The Contractor shall check and verify all dimensions and report any discrepancies to the Architect prior to construction; do not scale this drawing.
- This drawing shall not be used for construction unless properly noted as 'ISSUED FOR CONSTRUCTION' by the Architect.
- All dimensions are in millimeters unless noted otherwise.

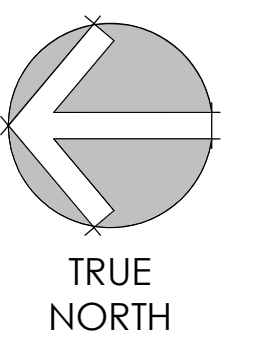

ISSUES/REVISIONS

DATE	DESCRIPTION	#
2017-02-20	ISSUED FOR PRICING	1
2017-04-11	ISSUED FOR TP2	2
2017-05-08	ISSUED FOR TP3	3
2017-06-19	ISSUED FOR TP4	5
2017-07-19	ISSUED FOR IFC	6
2018-09-12	ISSUED FOR AS-BUILTS	7

Seal


Client



Project Title  
**TRADES FACILITY EXPANSION**  
2700 COLLEGE WAY  
CRANBROOK, BC

Drawing Title  
**SECOND FLOOR PLAN**

Drawing info	Project Number
Scale 1:100	16-034
Date 11/07/16	Drawing Number
Drawn CPL	<b>A202</b>
Checked LM	
Partner LM	

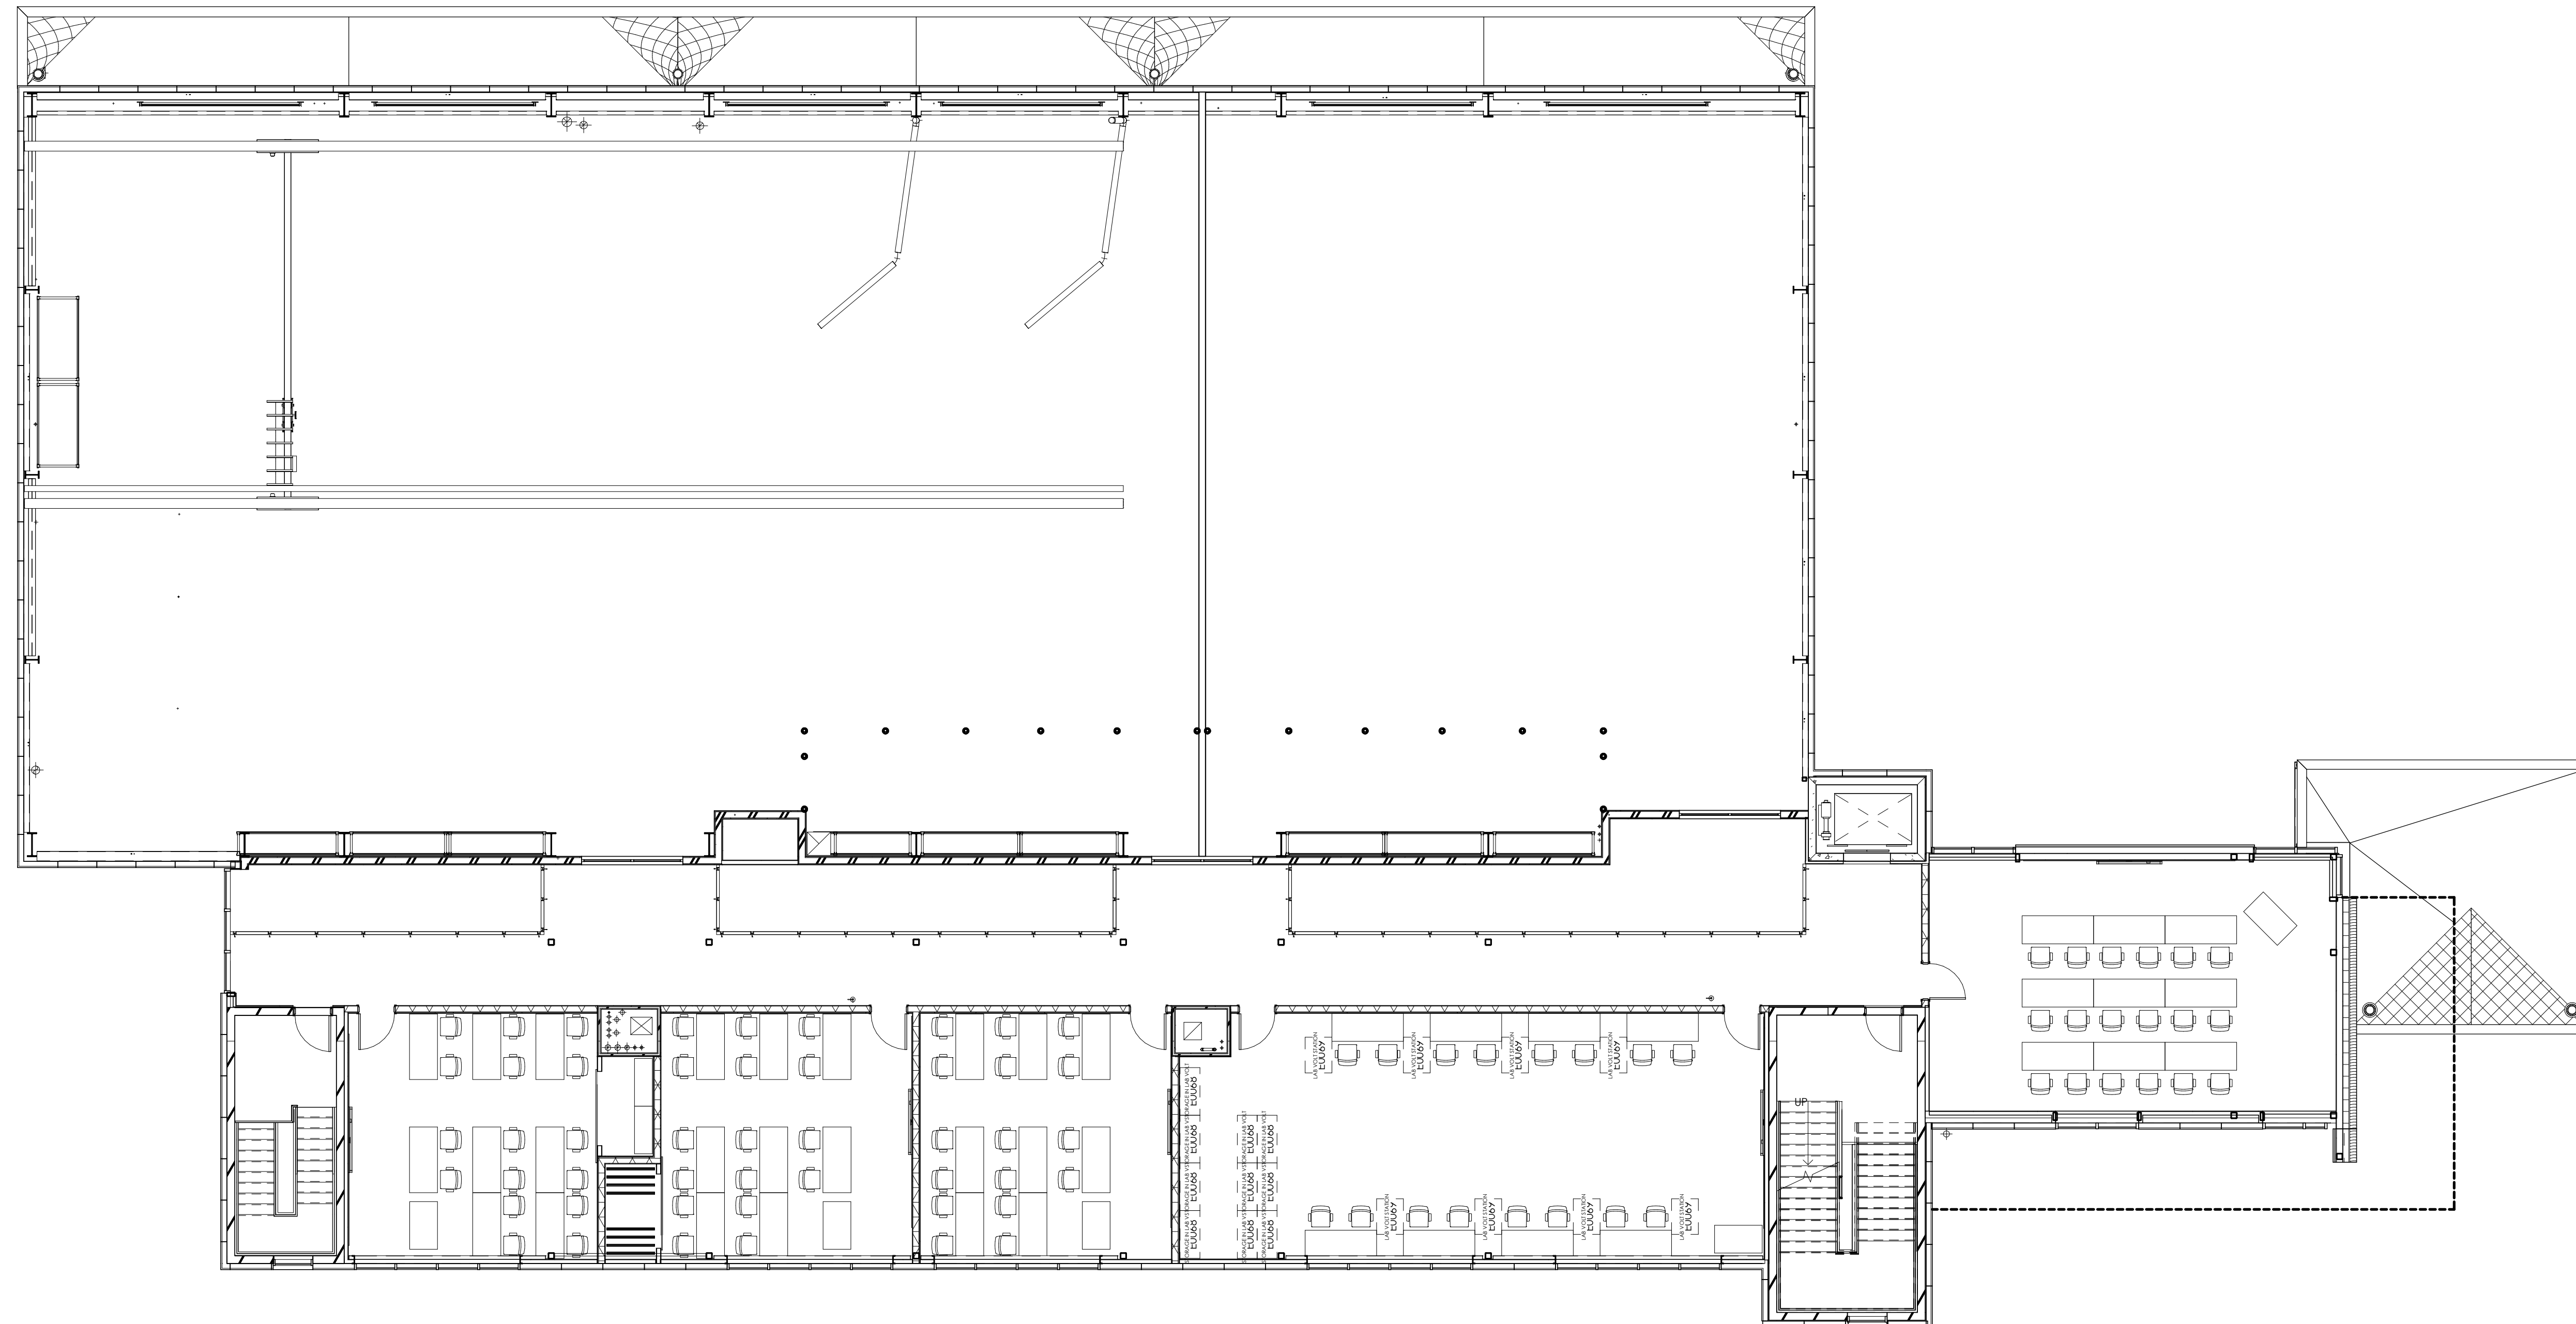

**1 SECOND FLOOR PLAN**  
1:100